


GILGIL-TOTAL TOWN STRETCH

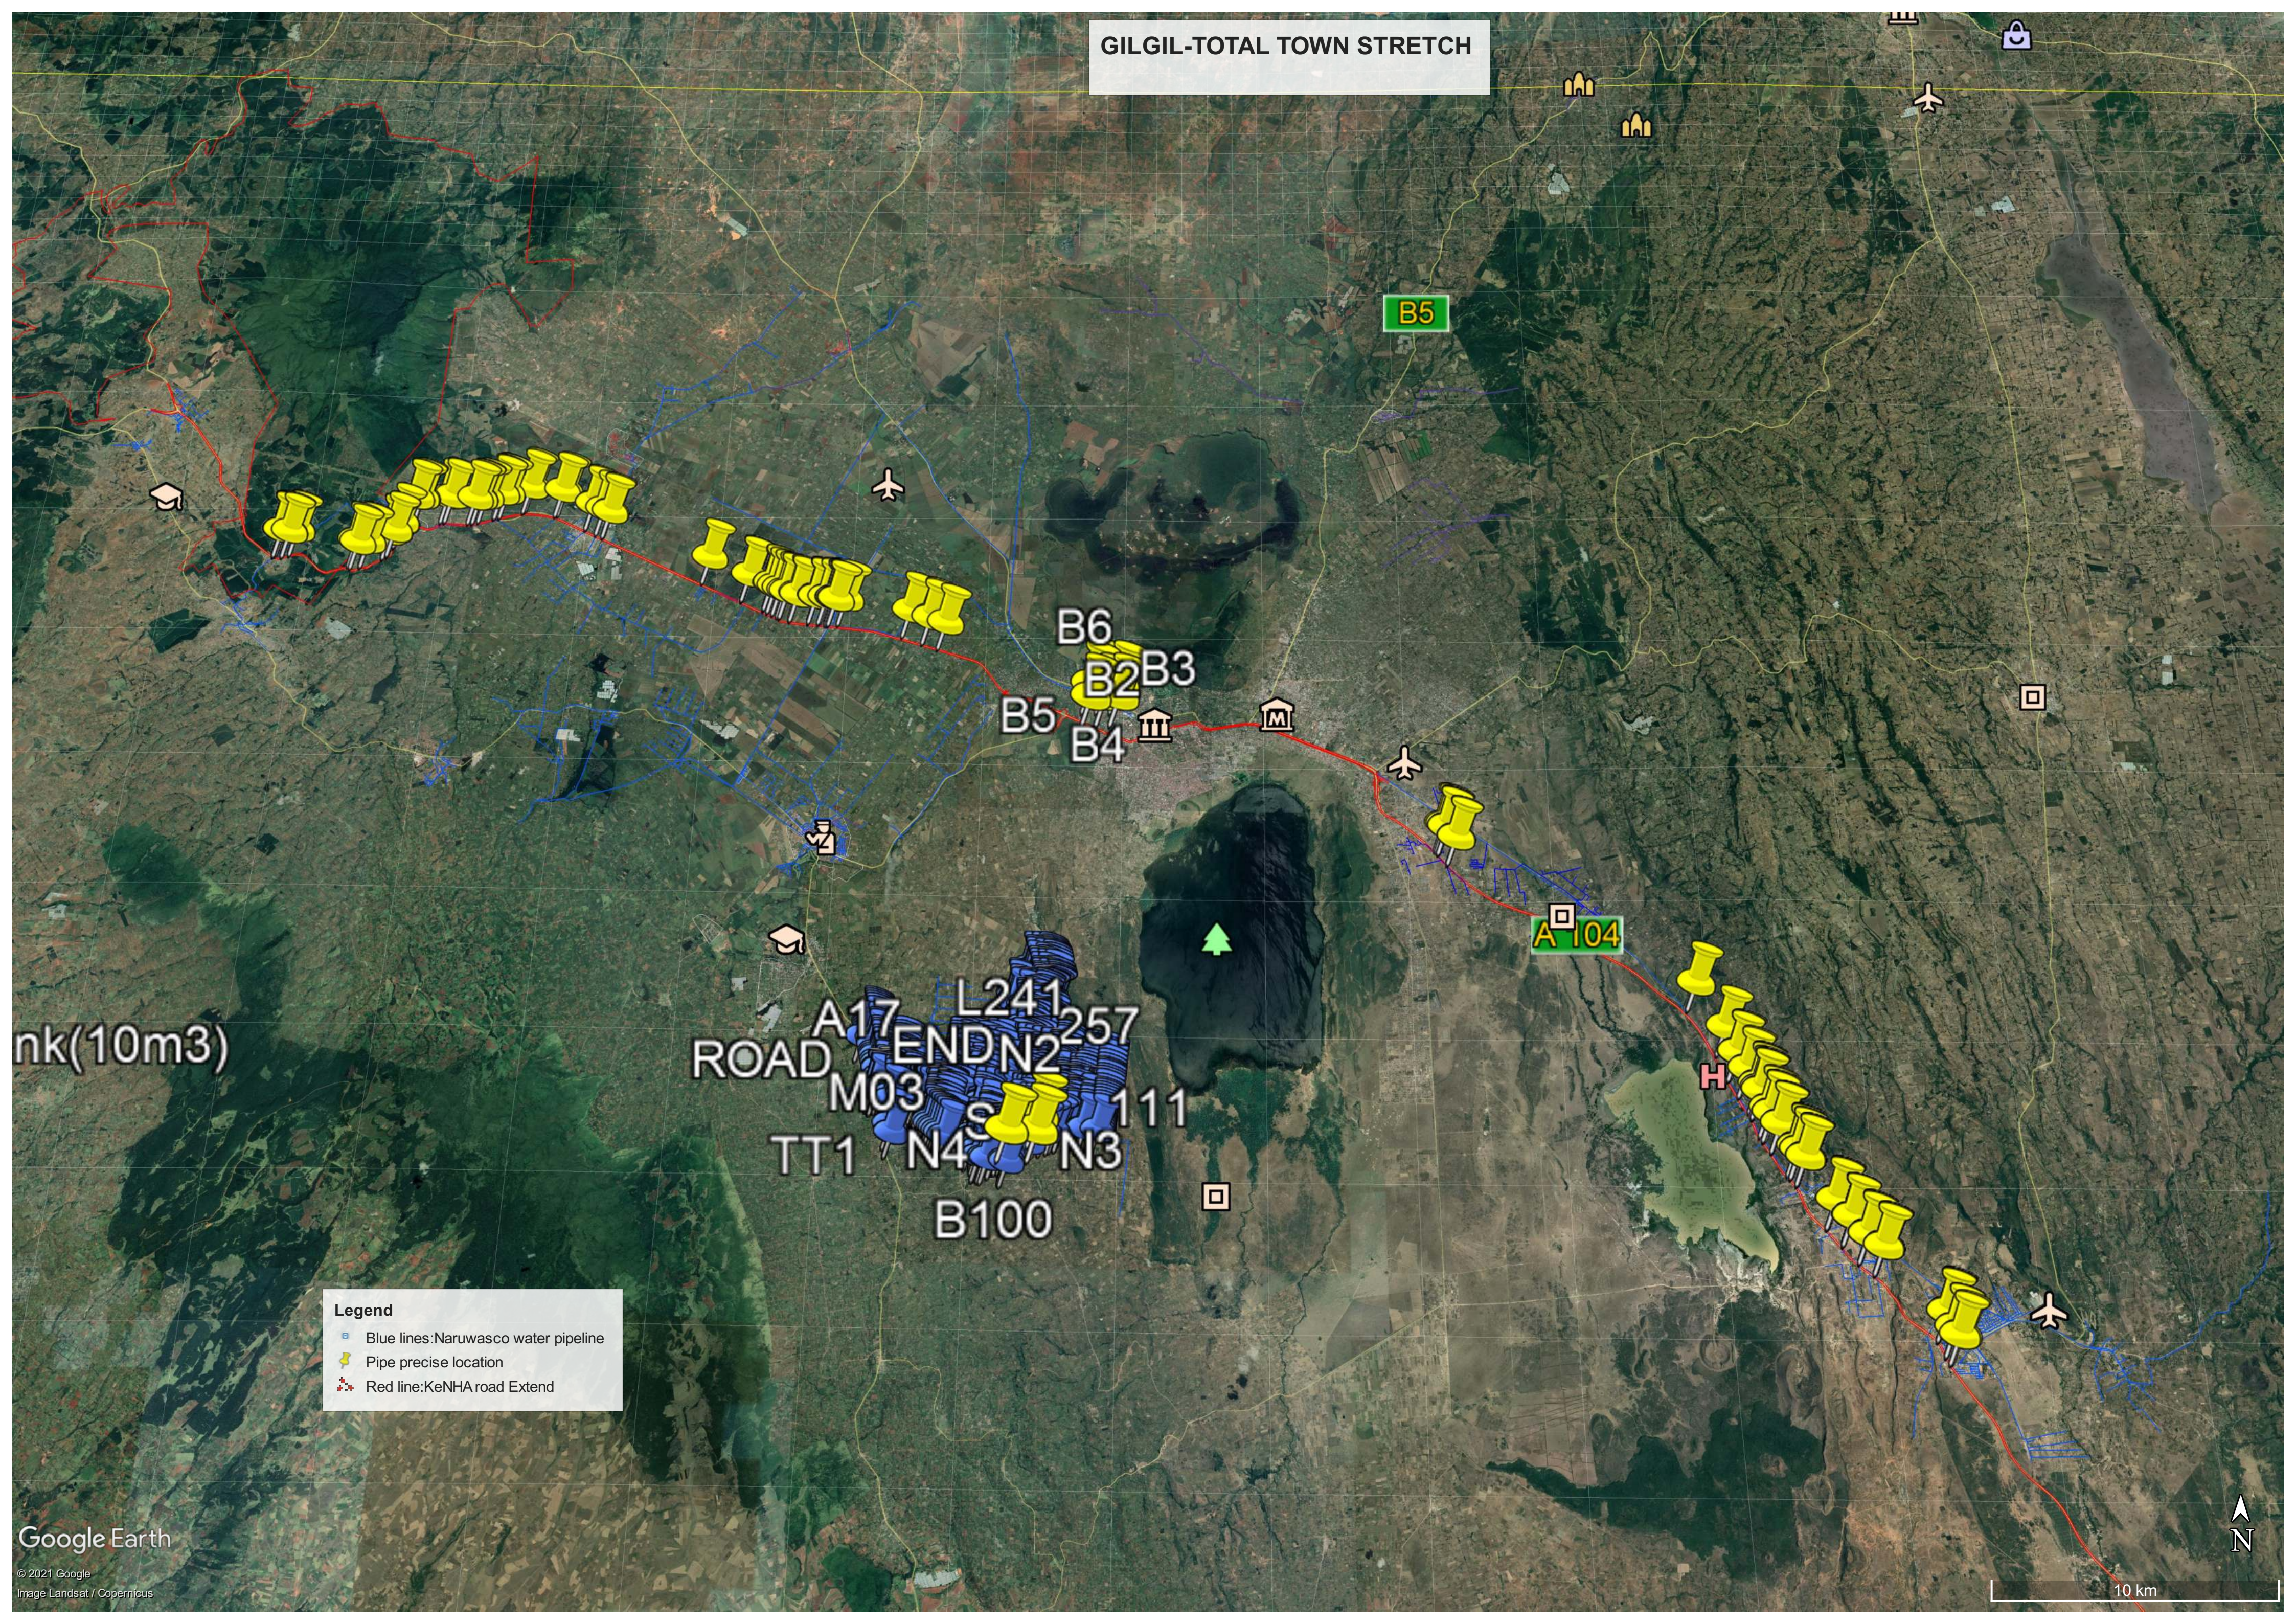

Legend

- Blue lines:Naruwasco water pipeline
- Pipe precise location
- Red line:KeNHA road Extend

nk(10m3)